


Service Required				
Service #	Location	Voltage (V)	Rating (kVA)	Utility Pole #
1	G6-9-3	208Y / 120	45	TBD by DU

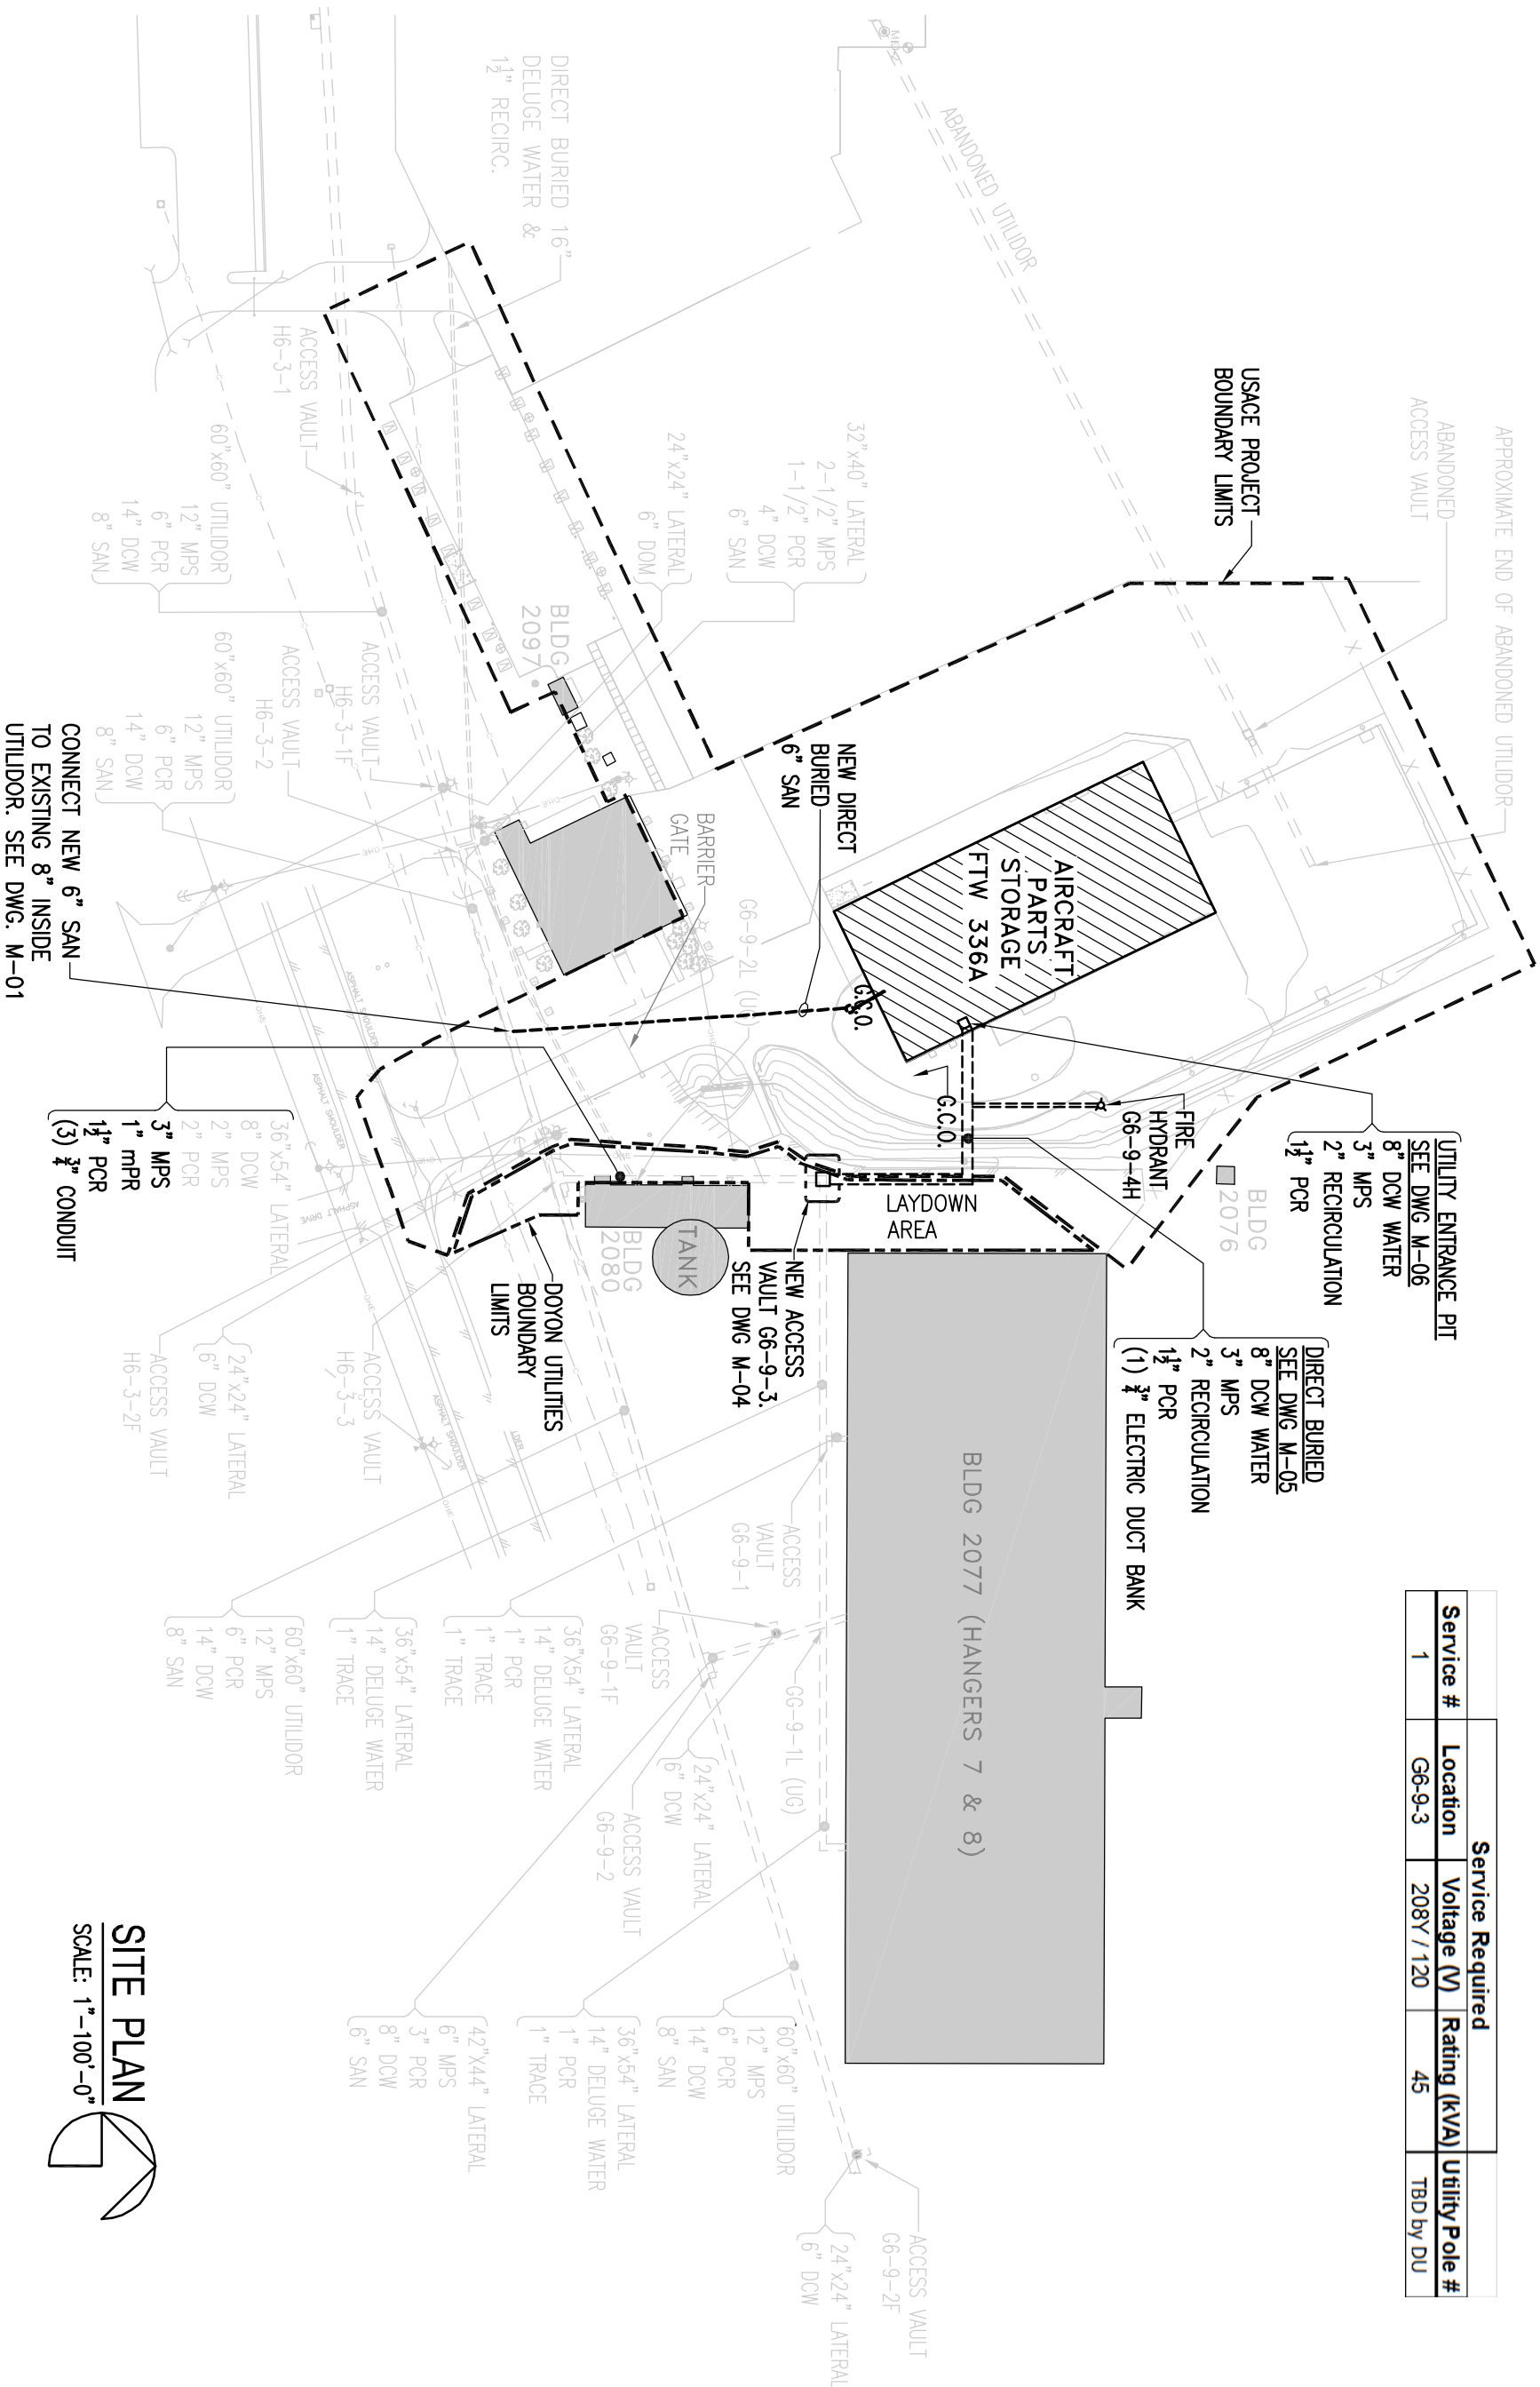

SITE PLAN
SCALE: 1"=100'-0"

REV. NO.	DATE	DESCRIPTION	Drawing No.	
0	05/09/11	RECORD DRAWING	G-01	
FOSDICK & HILMER 309 VINE STREET, SUITE 50 TELEPHONE (513) 241-5640			UTILITY SERVICE EXTENSION TO AIRCRAFT PARTS STORAGE SITE PLAN	
CONSULTING ENGINEERS CINCINNATI, OHIO 45202 WWW.FHENG.COM			FORT WAINWRIGHT, AK. DU PROJECT NO. J101395, J101396, J101397	
Jimmy Huntington Building 714 Fourth Avenue, Suite 20 Fairbanks, Alaska 99701 Telephone (907) 456-1560 Fax (907) 456-6788			Date: 19 FEB 2010 Scale: NTS Designed By: NEM Drawn By: NEM Checked By: NEM	