

UPPER LEVEL PLAN 


SCALE: $1/4'' = 1'-0''$

BUILDING 2080

 DRAWING NOTES:

- FIELD DEVICES SHALL BE WIRED TO CP-G693 IN VAULT G6-9-3.

UTILIDOR TO
VAULT H6-9-2

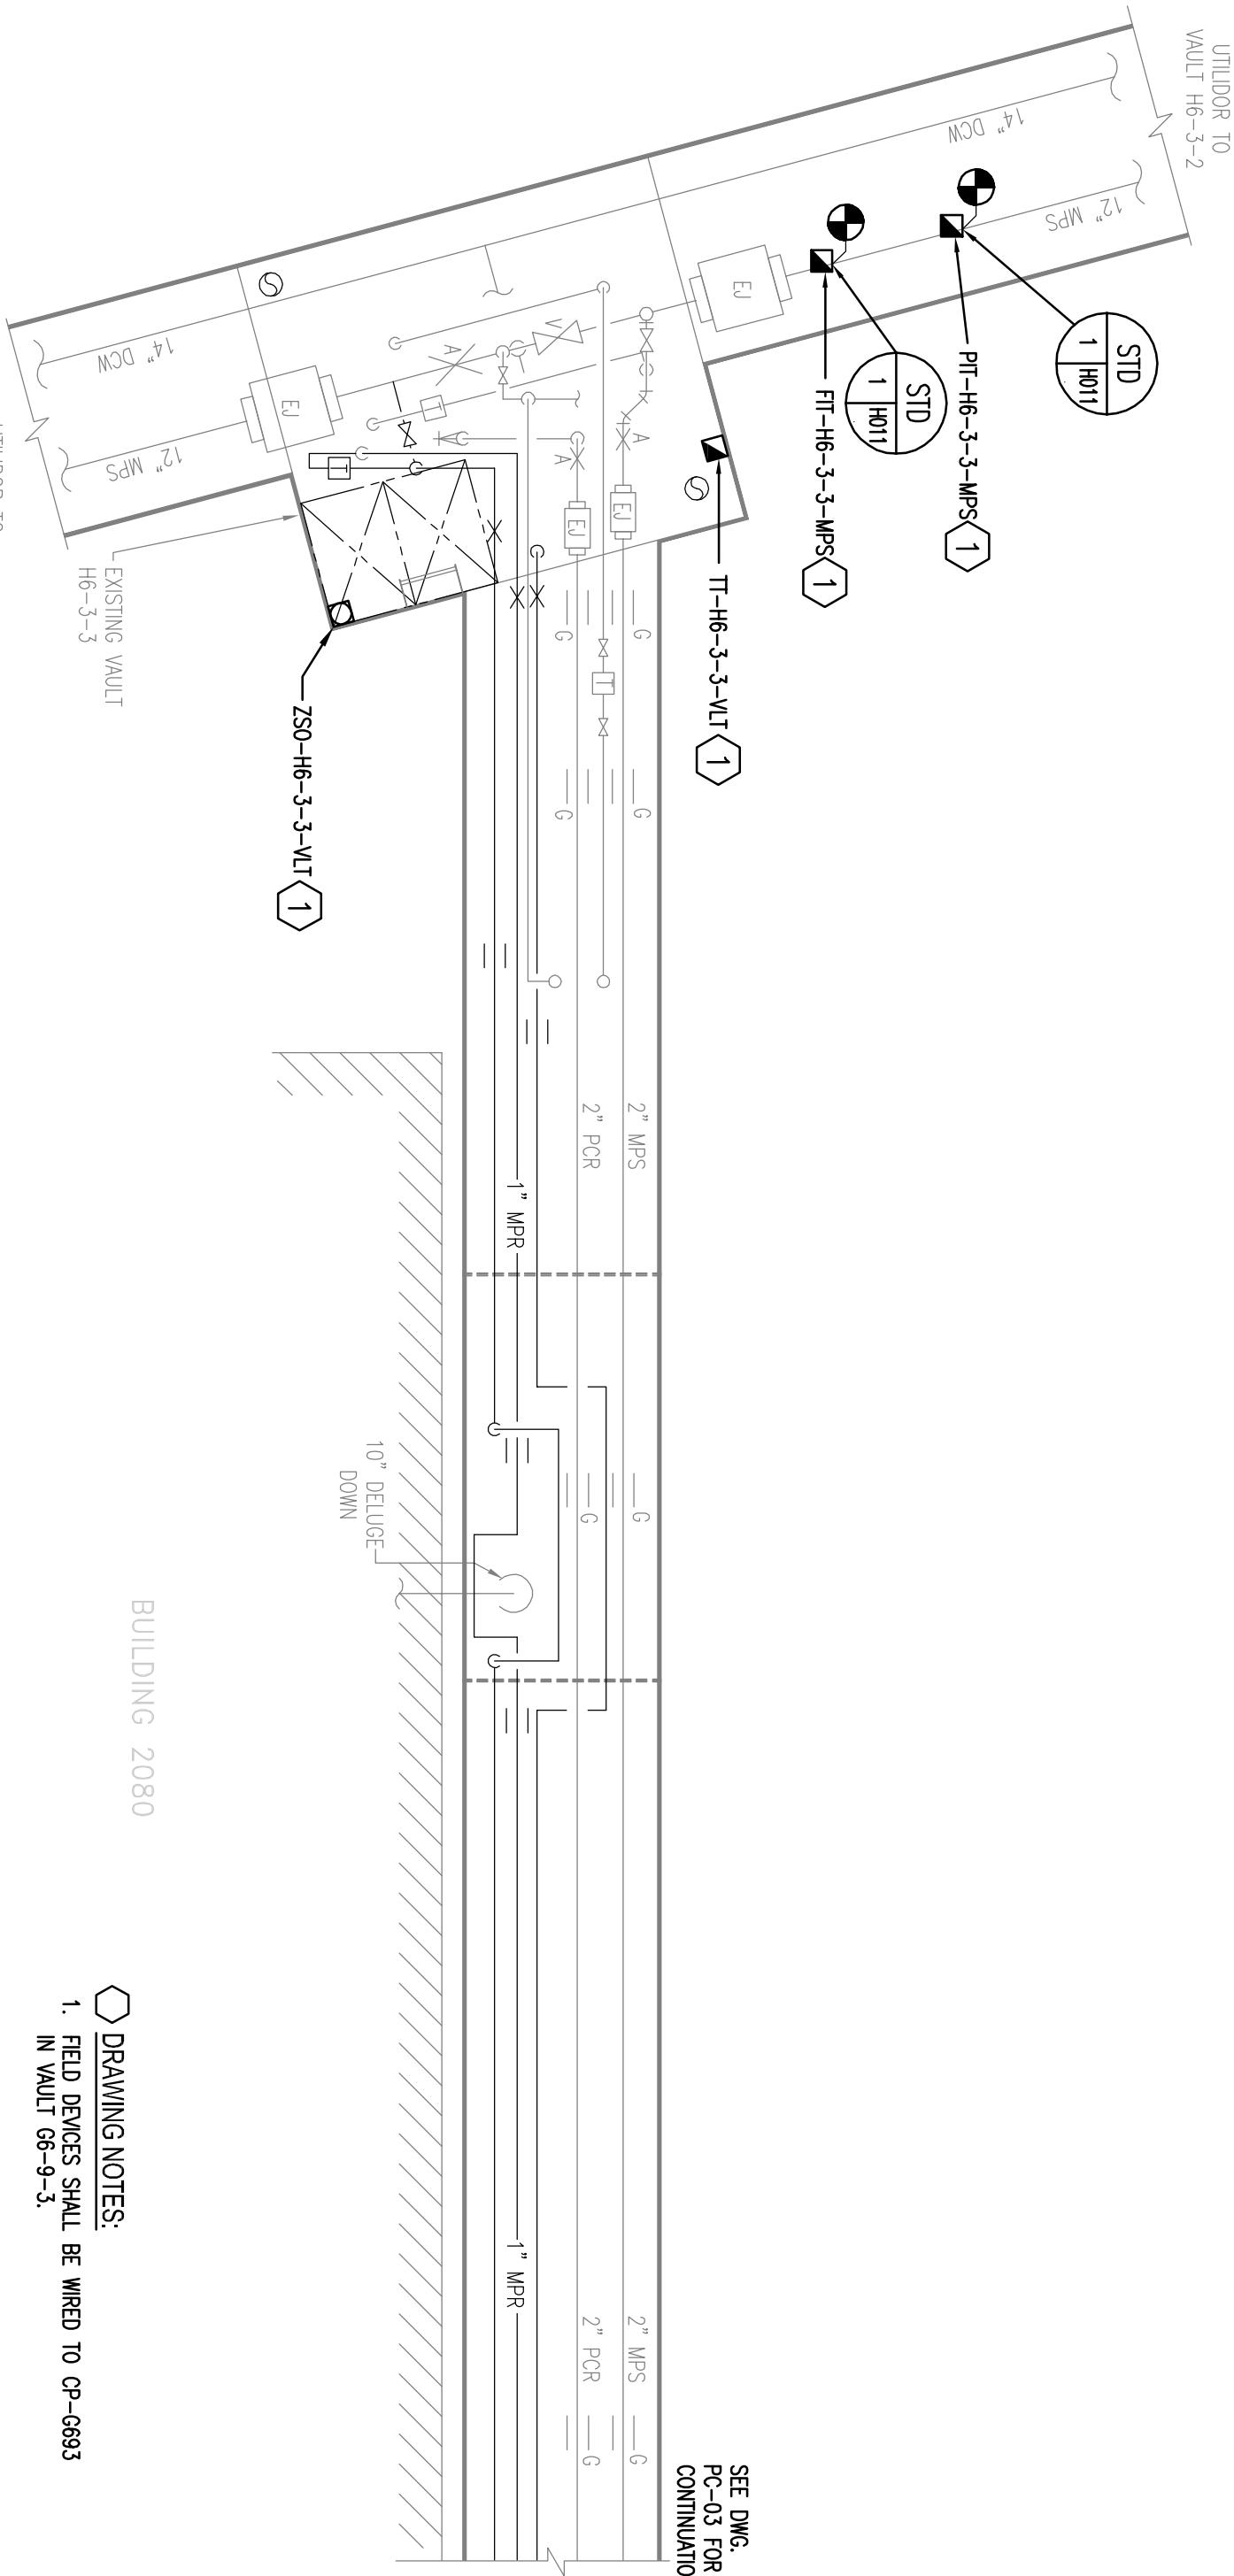

REV. NO.	DATE	DESCRIPTION
0	05/09/11	RECORD DRAWING
		FOSDICK & HILMER CONSULTING ENGINEERS 309 VINE STREET, SUITE 50 CINCINNATI, OHIO 45202 TELEPHONE (513)241-5640 WWW.FHENG.COM
		 DOYON UTILITIES 714 Fourth Avenue, Suite 20 Fairbanks, Alaska 99701 Telephone (907) 455-1500 Fax (907) 455-6788 DU PROJECT NO. J101395, 101396, 101397

Drawing No.

PC-02