


GENERAL NOTES:

A. RECEPTACLES SHALL BE MOUNTED 48" MINIMUM ABOVE UTILDOR (OR VAULT) FLOOR.

DRAWING NOTES:

1. PROVIDE POWER TO PANELBOARD FROM UTILITY POLE (TO BE DETERMINED, SEE DRAWING G-01). FURNISH AND INSTALL ELECTRICAL SERVICE PER UTILDOR SERVICE CONNECTION DETAIL (REFERENCE DRAWING E-07).
2. PROVIDE SQUARE D MODEL 853S8W61V02CS COMBINATION STARTER WITH CIRCUIT BREAKER-TYPE DISCONNECT, N.O./N.C. AUXILIARY CONTACTS (P/N: 9999-SX15), AND STANDARD TRIP THERMAL UNITS. CONTRACTOR SHALL WIRE TO RECIRCULATION PUMP, PROVIDING POWER TO STARTER AS INDICATED ON DRAWINGS.
3. FURNISH PANELBOARD PP-G693 WITH NEMA 4X ENCLOSURE AND CIRCUIT BREAKERS AS INDICATED ON PANELBOARD SCHEDULE (SEE DRAWING E-06).

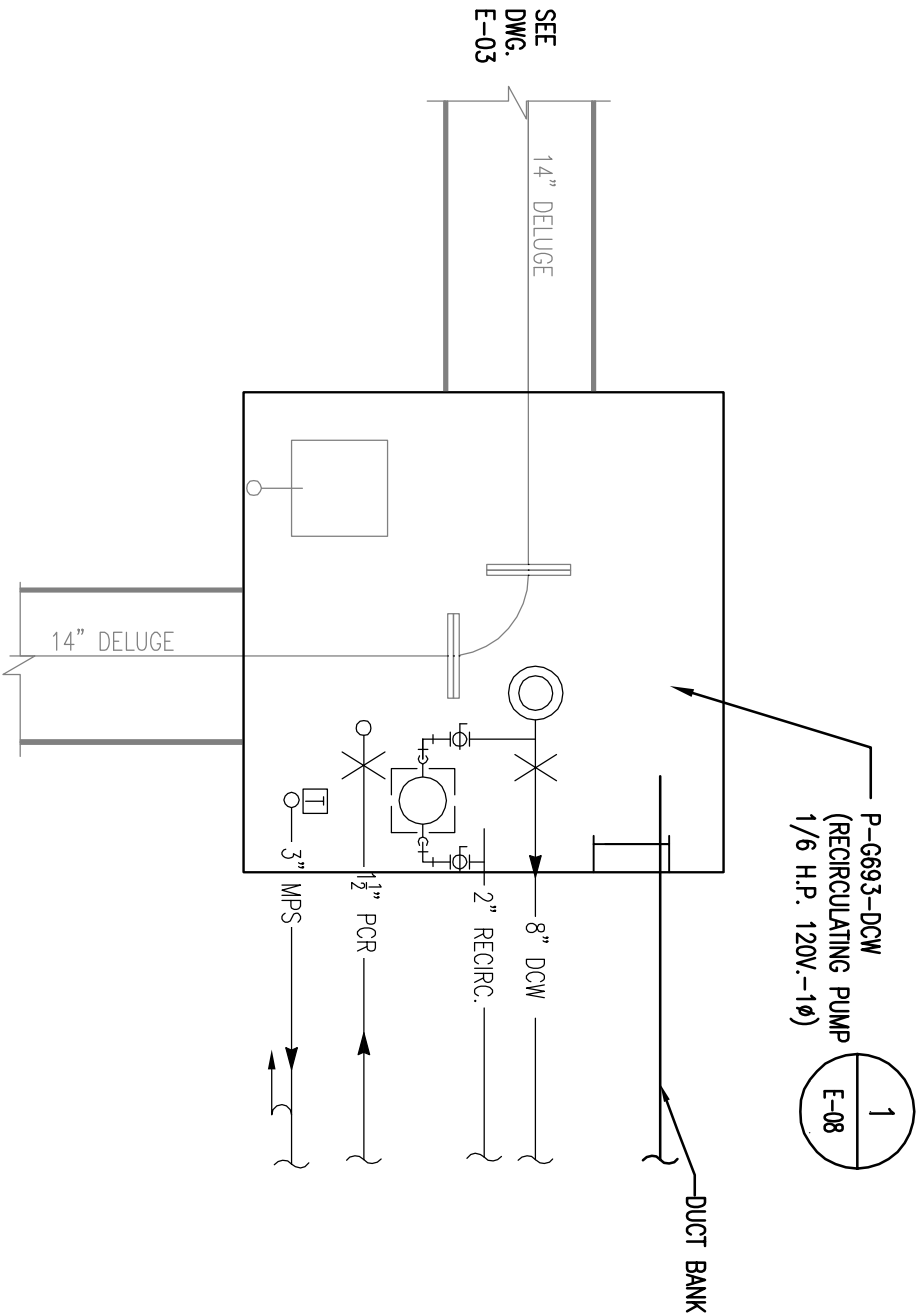

MID LEVEL PLAN

SCALE: 1/4"=1'-0"

LOWER LEVEL PLAN

SCALE: 1/4"=1'-0"

REV. NO.	DATE	DESCRIPTION	FOSDICK & HILMER 309 VINE STREET, SUITE 50 TELEPHONE (513)241-5640	CONSULTING ENGINEERS CINCINNATI, OHIO 45202 WWW.FHENG.COM	Jimmy Huntington Building 714 Fourth Avenue, Suite 20 Fairbanks, Alaska 99701 Telephone (907) 456-1500 Fax (907) 456-6788	Date: 19 FEB 2010 Scale: 1/4"=1'-0" Designed By: JRS Drawn By: RHW Checked By: EAE	UTILITY SERVICE EXTENSION TO AIRCRAFT PARTS STORAGE NEW VAULT G6-9-3 FORT WAINWRIGHT, AK. DU PROJECT NO. J101395, J101396, J101397	Drawing No. E-04
0	05/09/11	RECORD DRAWING						