
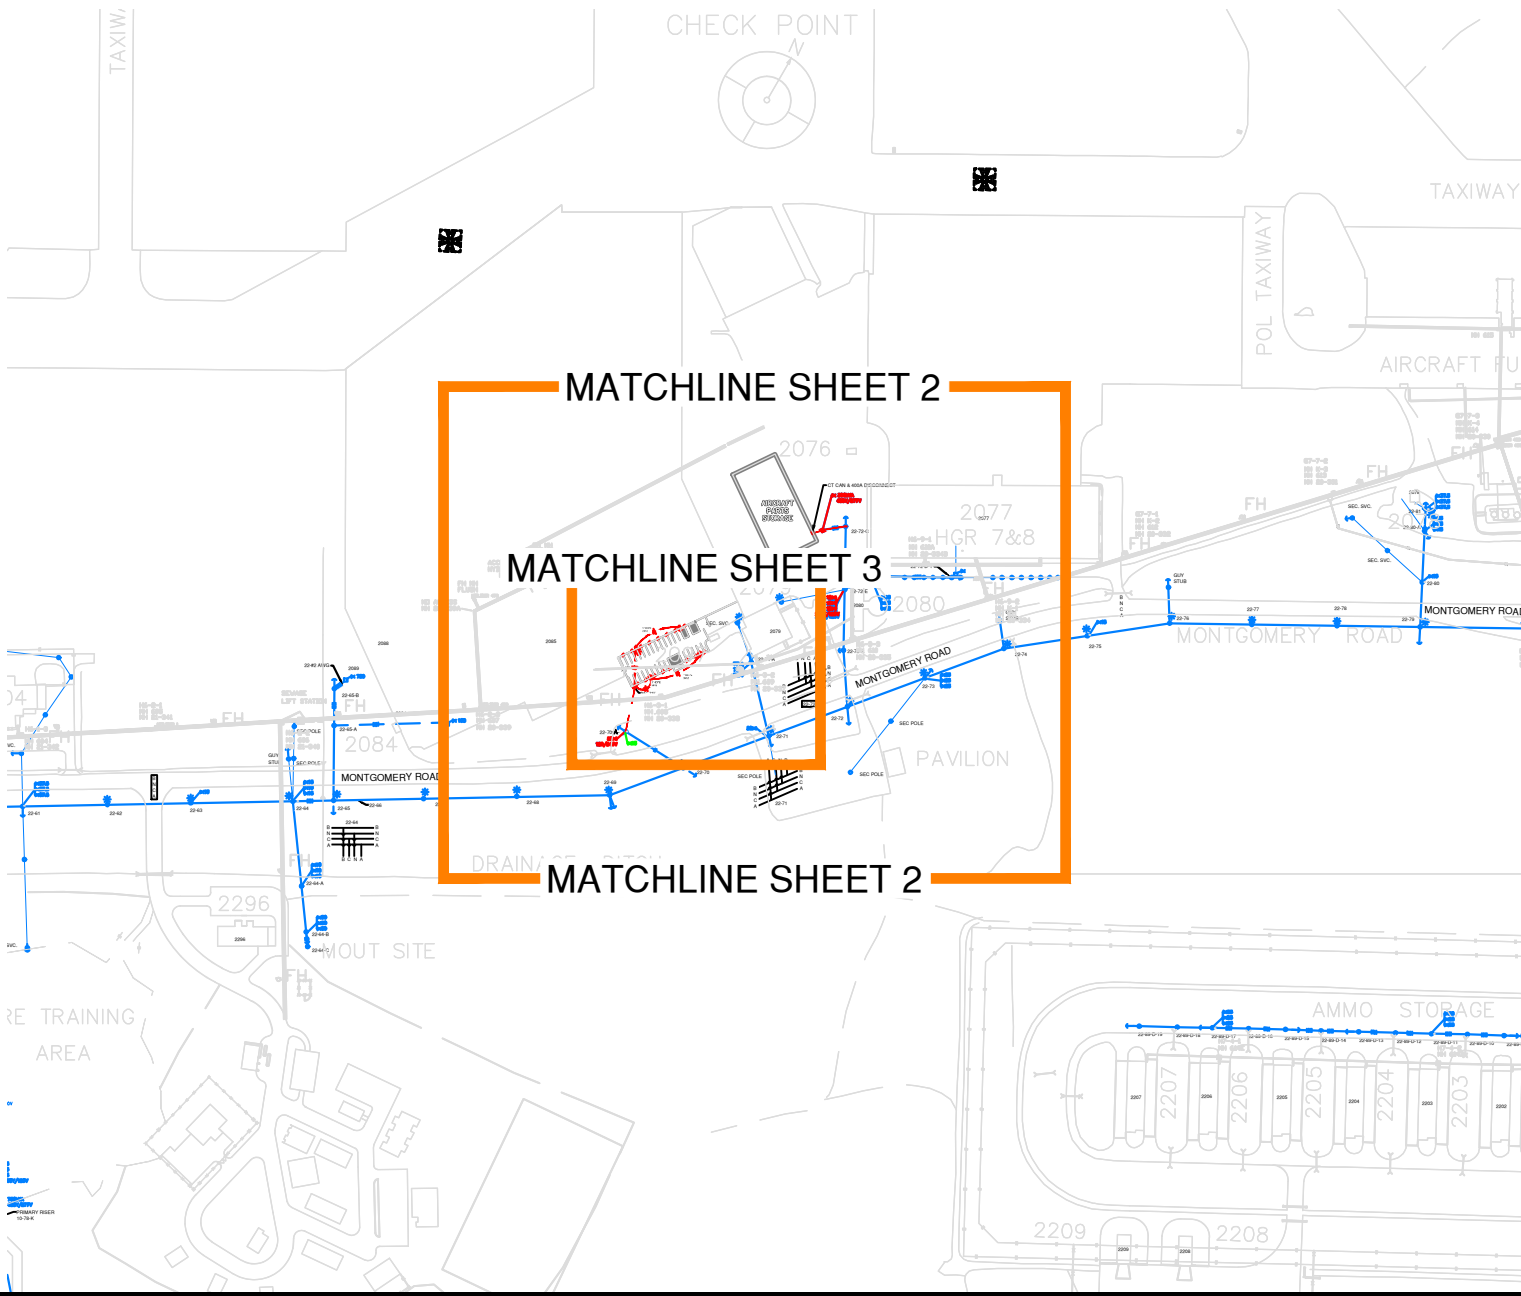


PROJECT: 09-0430
DATE: Jan 25, 11 - 10:52am
FILENAME: fw22-el-336a.dwg

LEGEND

1 PH OVERHEAD	==
3 PH OVERHEAD	===
1 PH UNDERGROUND	- - -
3 PH UNDERGROUND	- - - - -
EXISTING CONDUCTOR	
RETIRE/ABANDON CONDUCTOR	
REBUILD/REUSE CONDUCTOR	
NEW CONDUCTOR	
EXISTING POLE	○
RETIRE/ABANDON POLE	⊗
REUSE POLE/REPLACE ASSEMBLY	⊙
NEW POLE	●
RETIRE & REPLACE POLE	⊙
NEW POLE WITH NEW GUY POLE	●→
EXISTING DOWN GUY	→
RETIRE DOWN GUY	→
NEW DOWN GUY	→
EXISTING STREETLIGHT	*
REINSTALL STREETLIGHT	*
NOT IN CONTRACT (NIC)	

EXISTING PAD MOUNT TRANSFORMER	□
RETIRE PAD MOUNT TRANSFORMER	□
NEW PAD MOUNT TRANSFORMER	■
EXISTING POLE MOUNT TRANSFORMER (kVA)	⋈
RETIRE POLE MOUNT TRANSFORMER (kVA)	⋈
REINSTALL POLE MOUNT TRANSFORMER (kVA)	⋈
NEW POLE MOUNT TRANSFORMER (kVA)	⋈

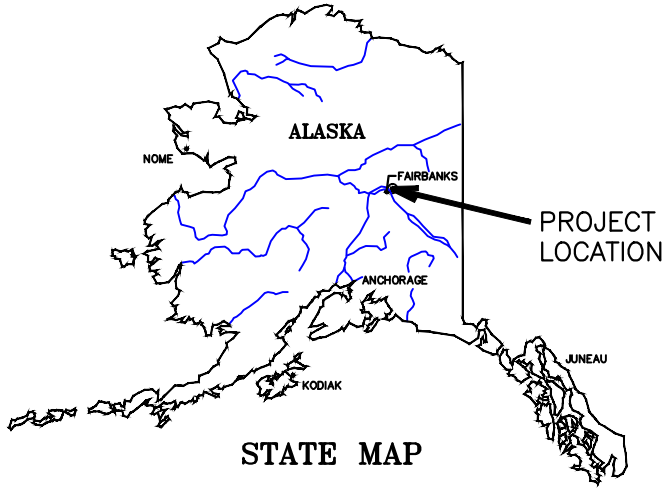

SHEET INDEX

DRAWING NAME	DRAWING NUMBERS
KEY PLAN	1
ELECTRICAL DISTRIBUTION PLANS	2, 3

GENERAL NOTES

1. PROVIDE POLE NUMBERING FOR ALL NEW/REVISED POLES AS INDICATED ON THE DRAWINGS. REFER TO DETAIL M1.3X PLACE NUMBERS ON ON POLE SIDE FACING ACCESS ROAD.

ENG. STAMP

NO.	DESIGN/CONSTRUCTION/ASBUILT	REVISION	DRAWN BY/DATE	REVIEW BY/DATE
A	ISSUED FOR REVIEW		CTD/01-15-2010	CTD/01-15-2010
B	ISSUED FOR REVIEW		CTD/04-02-2010	CTD/04-02-2010
C	AS-BUILT		CTD/01-18-2011	CTD/01-18-2011

DOYON UTILITIES, LLC
FORT WAINWRIGHT
AIRCRAFT PARTS STORAGE
US ARMY CORPS OF ENGINEERS # FTW336A
TITLE SHEET/KEY PLAN/LEGEND

North arrow pointing up. Scale bar showing 0 to 400 feet. Text: SCALE: 1"=400'. Logo for Dryden & LaRue, Inc. CONSULTING ENGINEERS.

DOYON UTILITIES LLC logo.

DOYON GRID NUMBER:
-

SHEET
1 OF 3

PROJECT: 09-0430
DATE: Jan 25, 11 - 11:03am
FILENAME: fw22-el-336a.dwg

MATCHLINE SHEET 1


MATCHLINE SHEET 1

MATCHLINE SHEET 1

NO.	DESIGN/CONSTRUCTION/AS-BUILT		REVISION		DRAWN BY/DATE		REVIEW BY/DATE	
	ISSUED FOR REVIEW	ISSUED FOR REVIEW	ISSUED FOR REVIEW	ISSUED FOR REVIEW	CTD/01-15-2010	CTD/01-15-2010	CTD/01-15-2010	CTD/01-15-2010
A								
B								
C								
AS-BUILT								


ENG. STAMP


DOYON UTILITIES, LLC
FORT WAINWRIGHT
AIRCRAFT PARTS STORAGE
US ARMY CORPS OF ENGINEERS # FTW336A
ELECTRICAL DISTRIBUTION PLAN

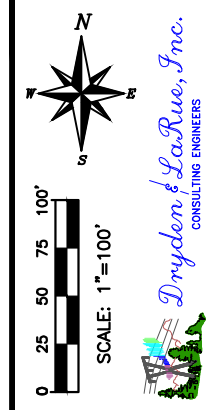

DOYON GRID NUMBER:
CP-30-06
(PARTIAL)

SHEET
2 OF 3

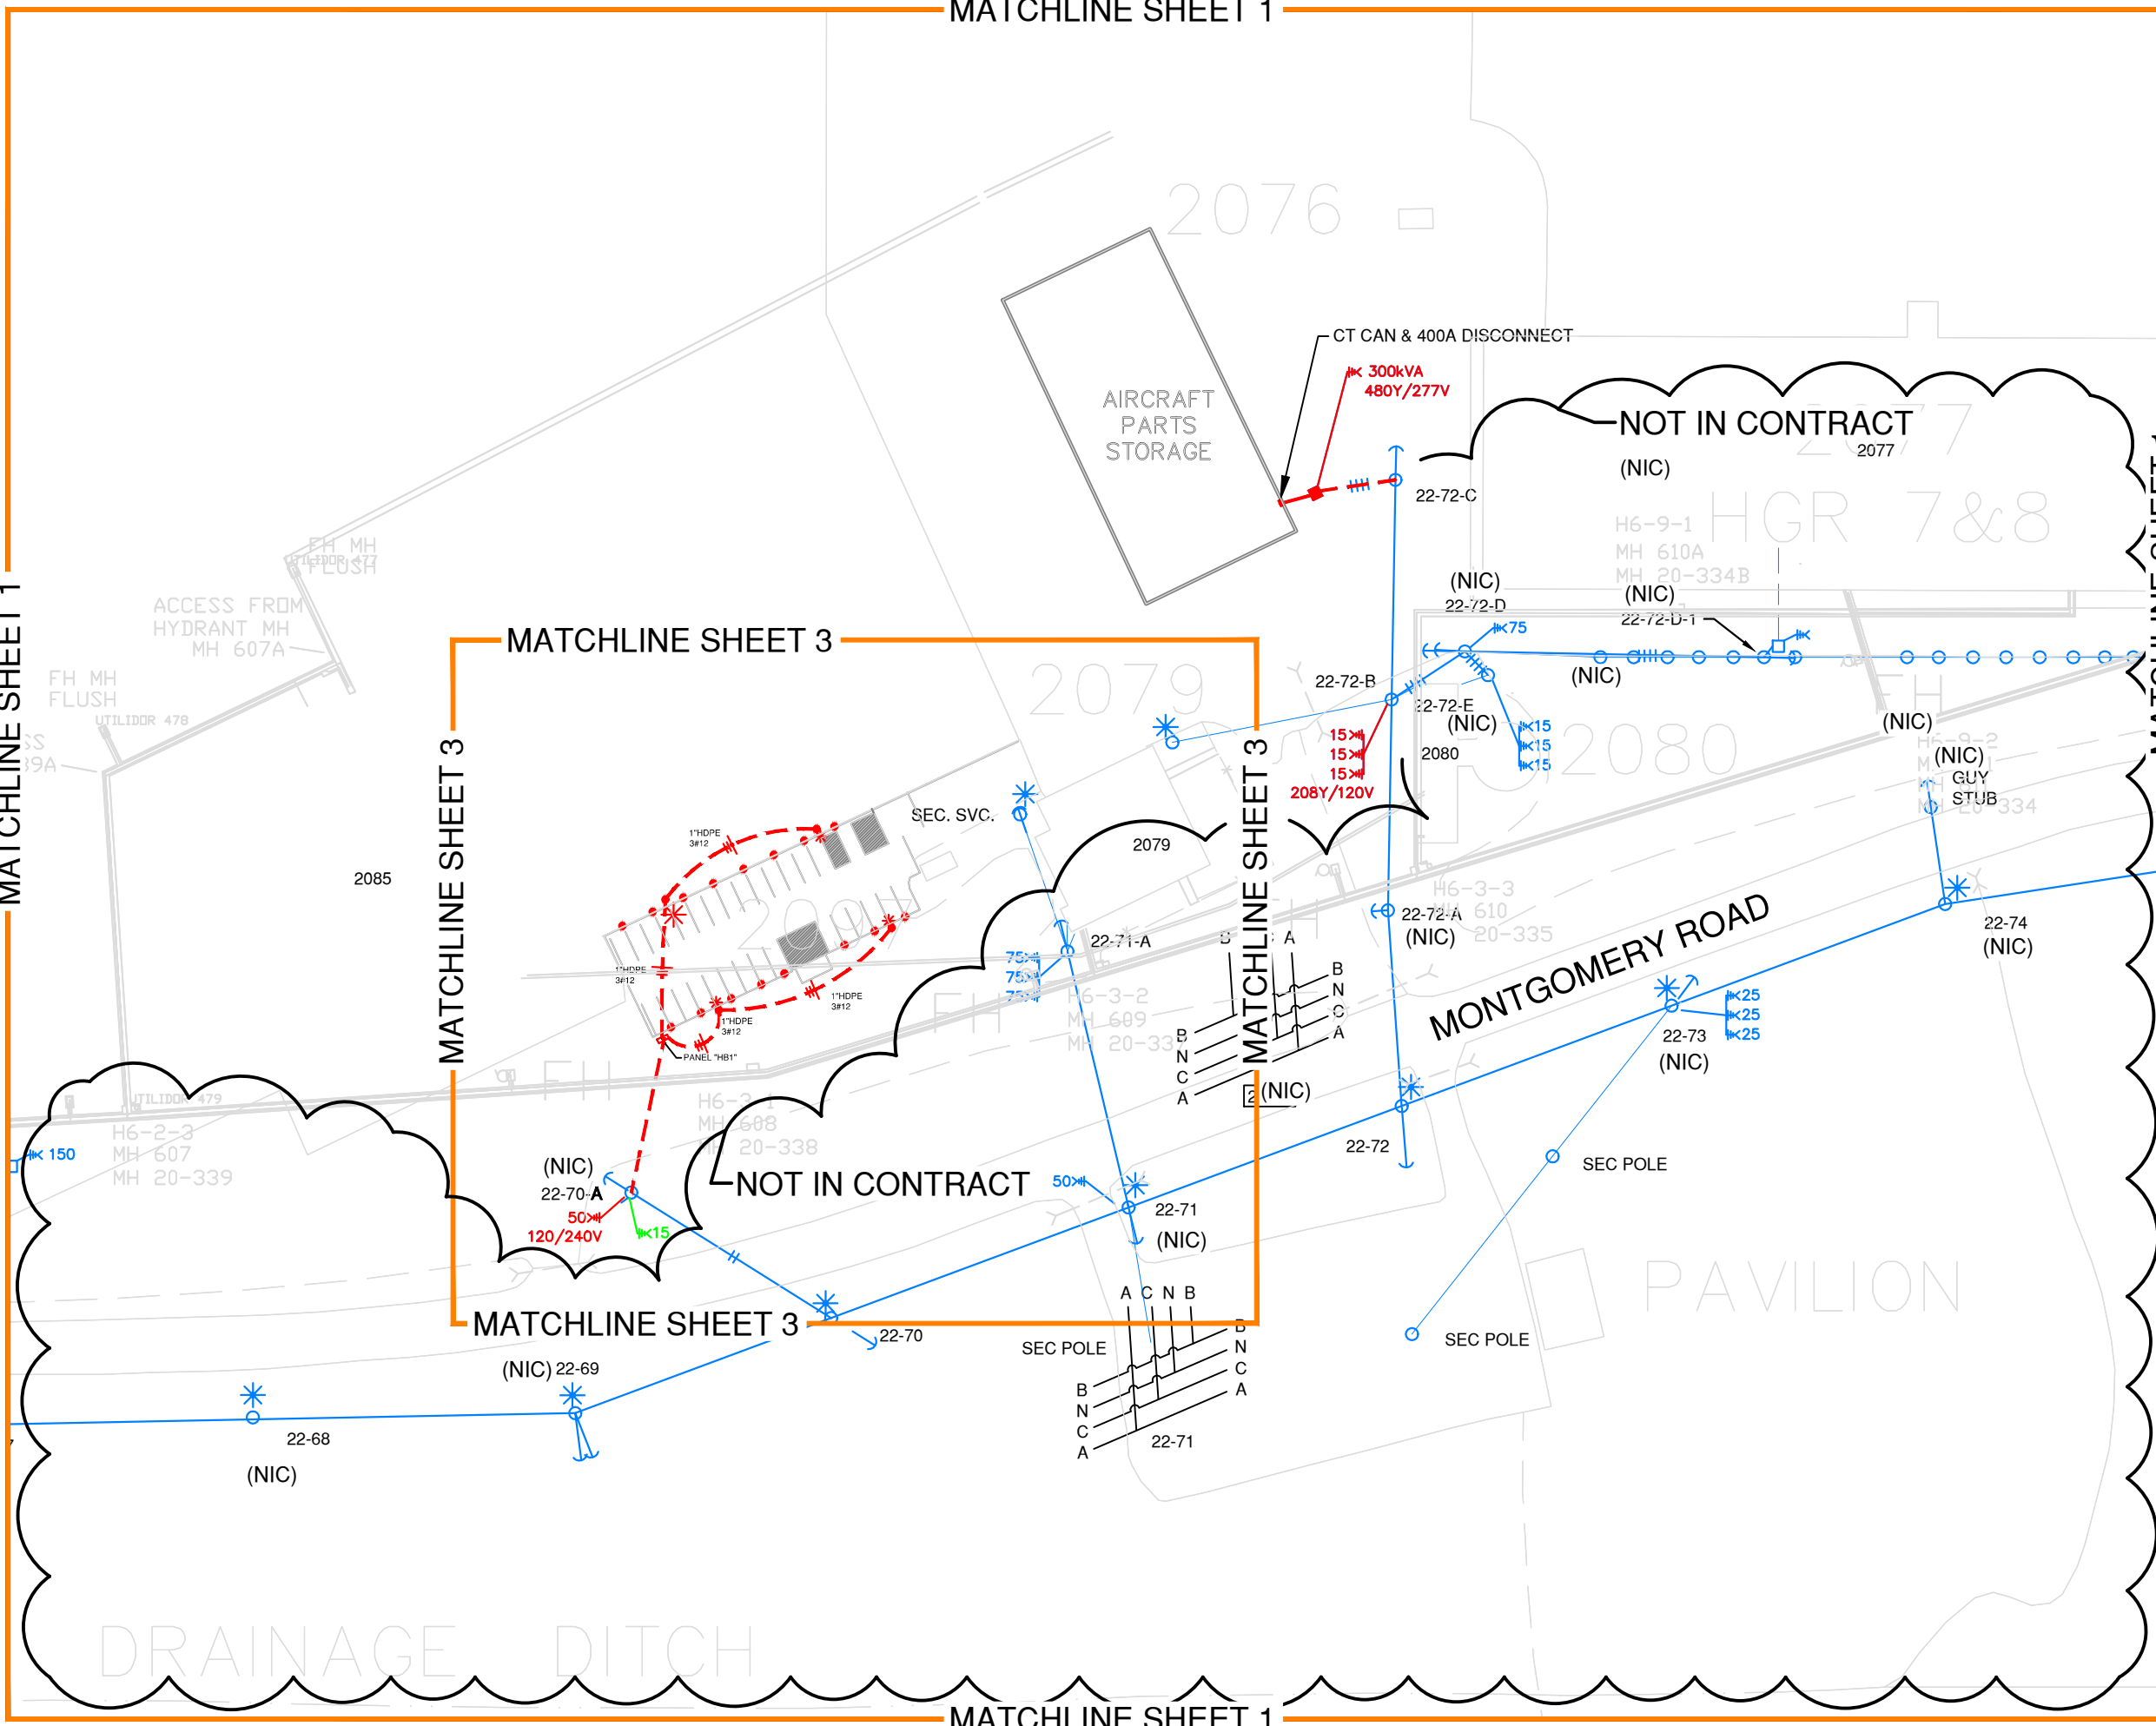


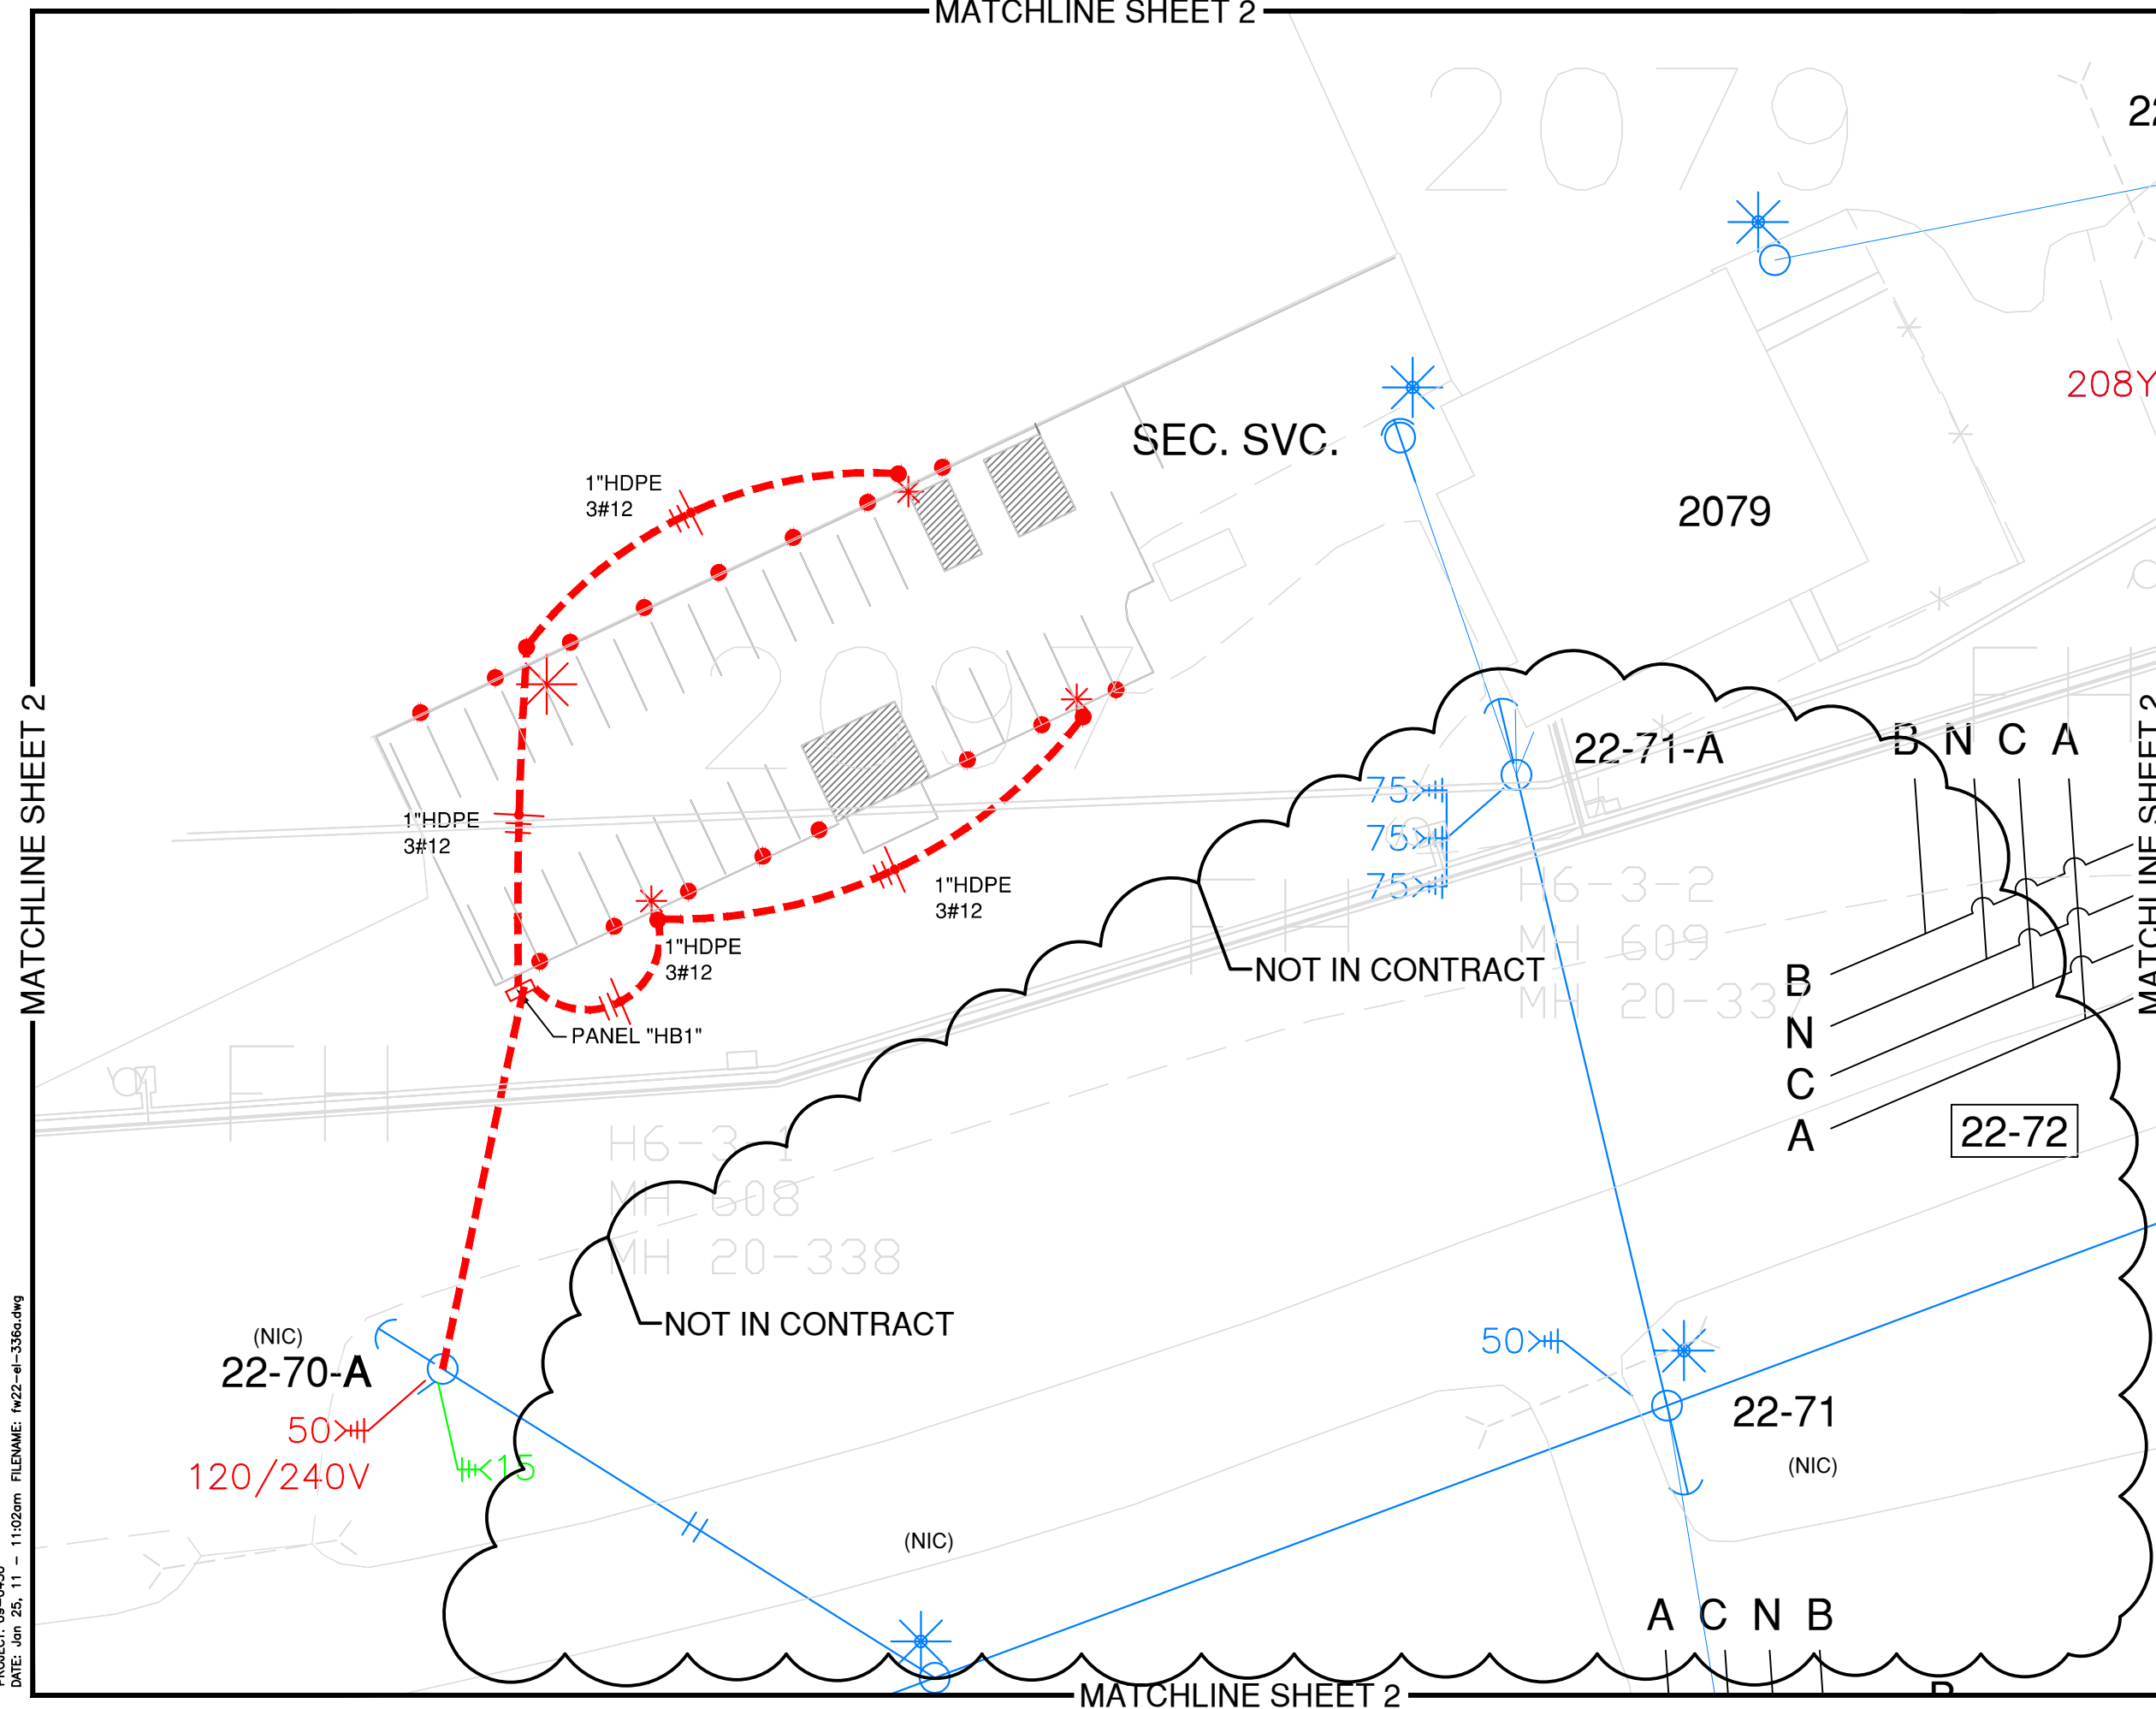

ENG. STAMP

[illegible]

DOYON UTILITIES, LLC
FORT WAINWRIGHT
AIRCRAFT PARTS STORAGE
US ARMY CORPS OF ENGINEERS # FTW336A
ELECTRICAL DISTRIBUTION PLAN

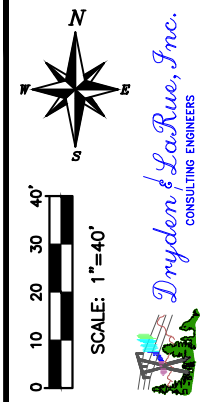

DOYON GRID
NUMBER:

**CP-30-06
(PARTIAL)**

SHEET
OF 3