




DETAIL 1 ACCESS VAULT G6-9-3
SCALE: 1/2" = 1'-0" S2

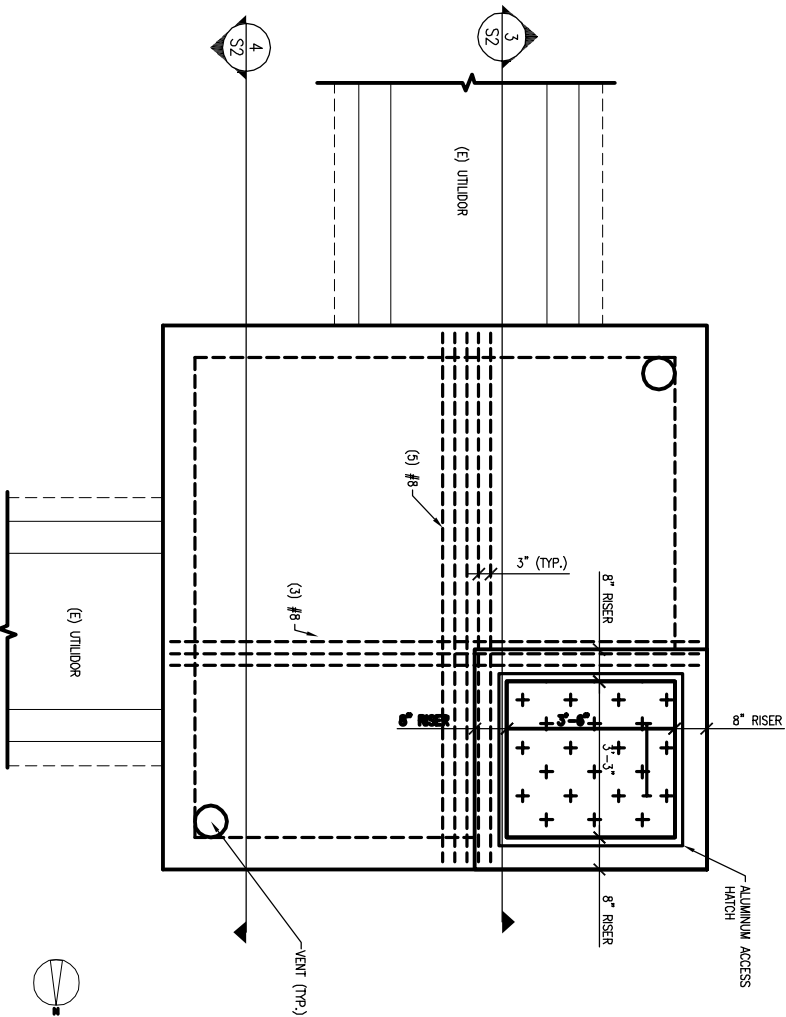

DETAIL 2 ACCESS VAULT G6-9-3
SCALE: 1/2" = 1'-0" S2

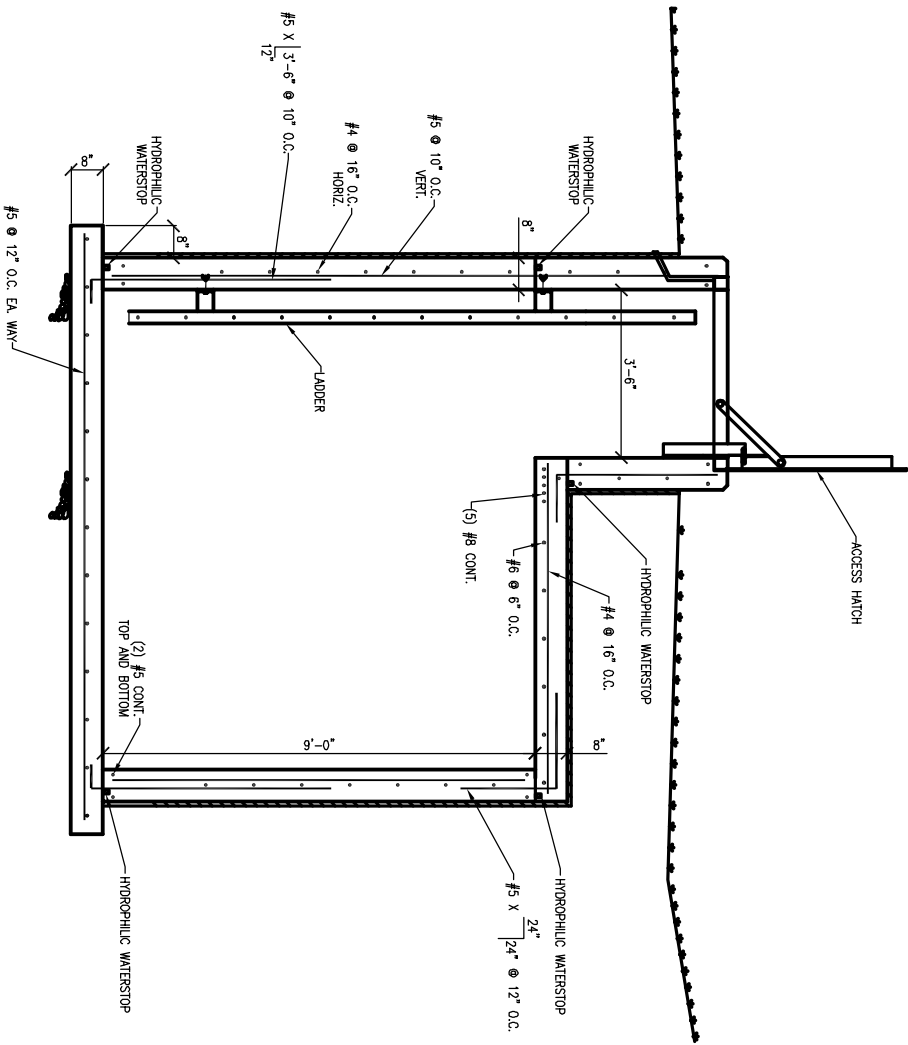

DETAIL 3 ACCESS VAULT G6-9-3
SCALE: 1/2" = 1'-0" S2

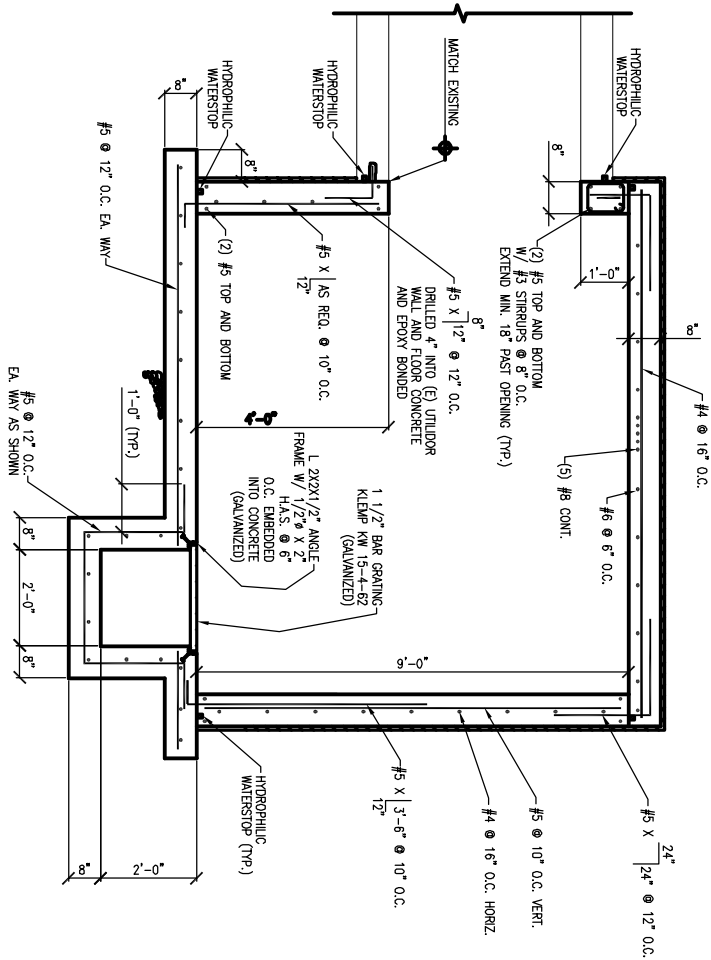

DETAIL 4 ACCESS VAULT G6-9-3
SCALE: 1/2" = 1'-0" S2

Date Stamped: 8/20/2010		By	
0	5/09/11	RECORD DRAWING	

USKH
Sue Bryant, Project Engineer
Architecture • Engineering • Surveying
Planning • Environmental Services

2515 N. Street
Suite 201
Fairbanks, Alaska 99701
(907) 452-2728
3017 Chitina Drive
Suite 201
Lutetia, Alaska 99701
(907) 730-0201
351 W. Parks Highway
Suite 200
Fairbanks, Alaska 99701
(907) 376-7815
441 W. 5th Avenue,
Suite 200
Anchorage, Alaska 99501
(907) 276-0885

www.uskh.com

Project:
TUNISTA/
FTW 336A

TUNISTA
FT. WAINWRIGHT, ALASKA

Project Mgr.	FST	
Drawn	GL	
Checked	GL	
Date		

Sheet Contents:
ACCESS VAULT
G6-9-3
PLANS AND
SECTIONS

Sheet No.:

S2

USKH W.O. 1267800