



UPPER LEVEL PLAN
SCALE: 1/4"=1'-0"

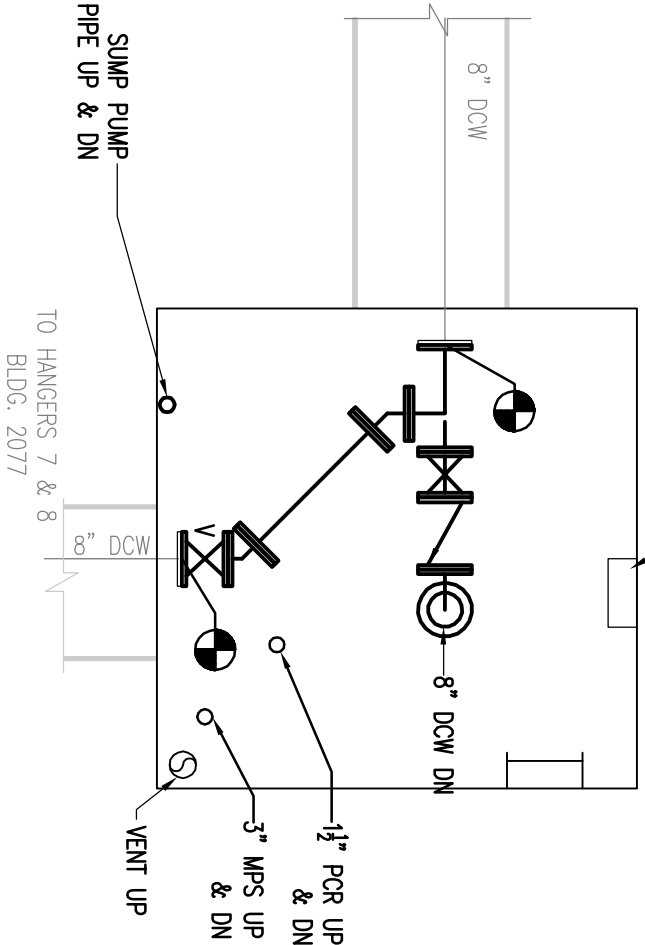

MID LEVEL PLAN
SCALE: 1/4"=1'-0"

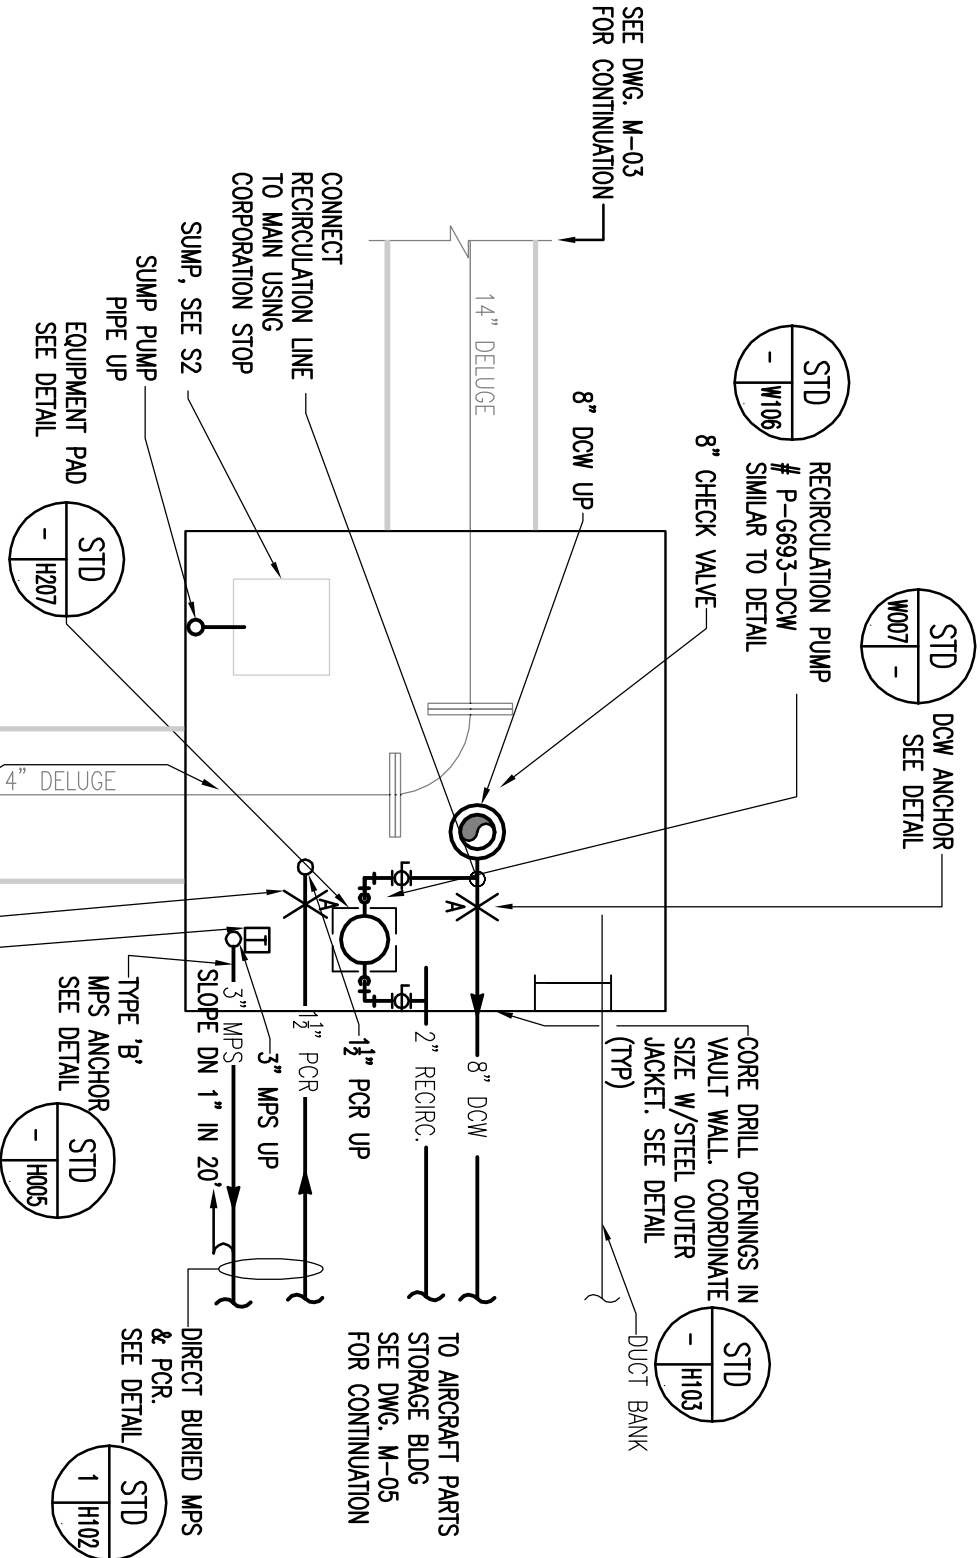

LOWER LEVEL PLAN
SCALE: 1/4"=1'-0"

REV. NO.	DATE	DESCRIPTION	DESIGNED BY	CHECKED BY	DRAWING NO.
0	05/09/11	RECORD DRAWING	JRS	EAE	M-04
		FOSDICK & HILMER CONSULTING ENGINEERS 309 VINE STREET, SUITE 50 CINCINNATI, OHIO 45202 TELEPHONE (513)241-5640 WWW.FHENG.COM	Jimmy Huntington Building 714 Fourth Avenue, Suite 20 Fairbanks, Alaska 99701 Telephone (907) 455-1500 (907) 455-6788 Fax (907) 455-6788		
UTILITY SERVICE EXTENSION TO AIRCRAFT PARTS STORAGE			FORT WAINWRIGHT, AK.		
NEW VAULT G6-9-3			DU PROJECT NO. J101395, J101396, J101397		