


BUILDING 2080

UPPER LEVEL PLAN
SCALE: 1/4"=1'-0"

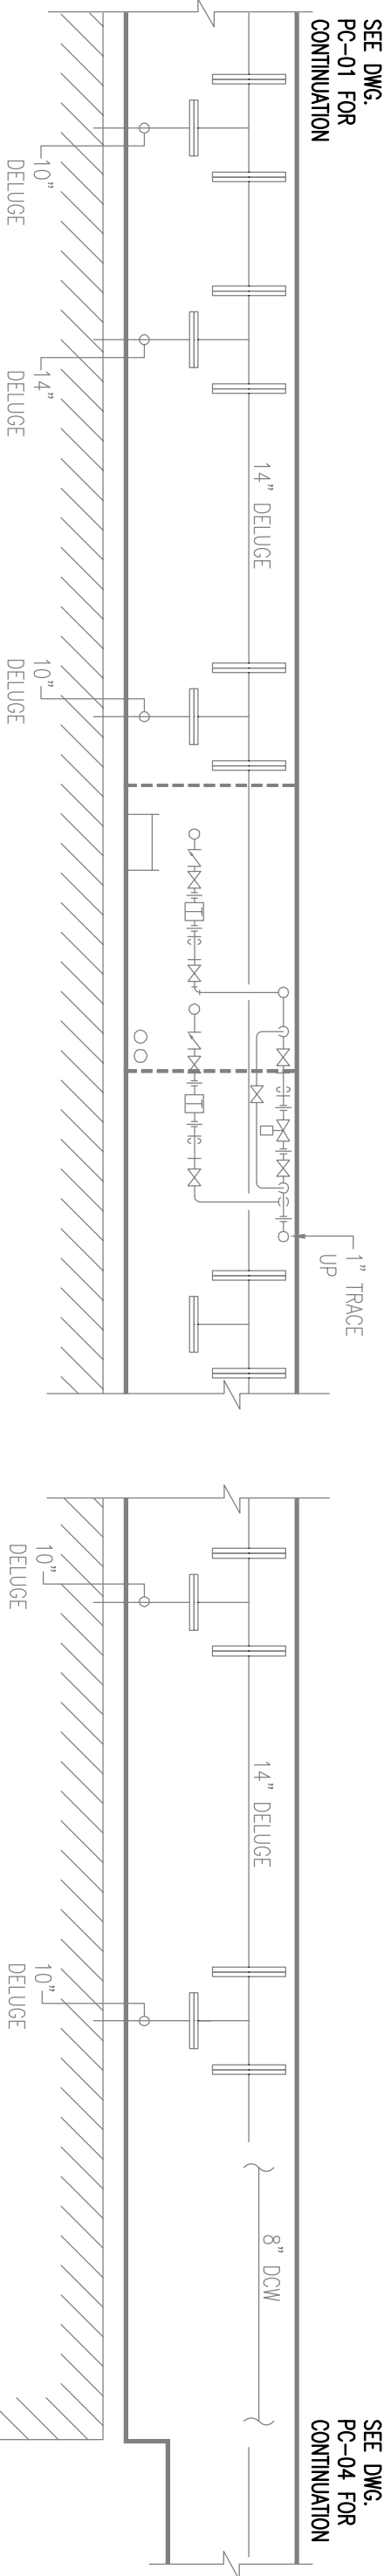

BUILDING 2080

LOWER LEVEL PLAN
SCALE: 1/4"=1'-0"



NOTE: NO NEW DISCIPLINE WORK SHOWN
ON THIS DRAWING.

REV. NO.	DATE	DESCRIPTION	DATE:	19 FEB 2010	UTILITY SERVICE EXTENSION TO AIRCRAFT PARTS STORAGE	Drawing No.
0	05/09/11	RECORD DRAWING	Scale:	1/4"=1'-0"	EXISTING VAULT H6-3-3 & NEW VAULT G6-9-3	PC-03
			Designed By:	JRS		
			Drawn By:	RHW	FORT WAINWRIGHT, AK.	
			Checked By:	EAE	DU PROJECT NO. J101395, 101396, 101397	

FOSDICK BILLMER
309 VINE STREET, SUITE 50
TELEPHONE (513)241-5640

CONSULTING ENGINEERS
CINCINNATI, OHIO 45202
WWW.FHENG.COM

DOYON UTILITIES

Jimmy Huntington Building
714 Fourth Avenue, Suite 20
Palmbanks, Alaska 99701
Telephone (907) 455-1500
Fax (907) 455-6788