


SEE
DWG.
E-02

SEE
DWG.
E-04

UPPER LEVEL PLAN 
SCALE: 1/4"=1'-0"


(2)#12, (1)#12G, 3/4"C
PP-G693-10

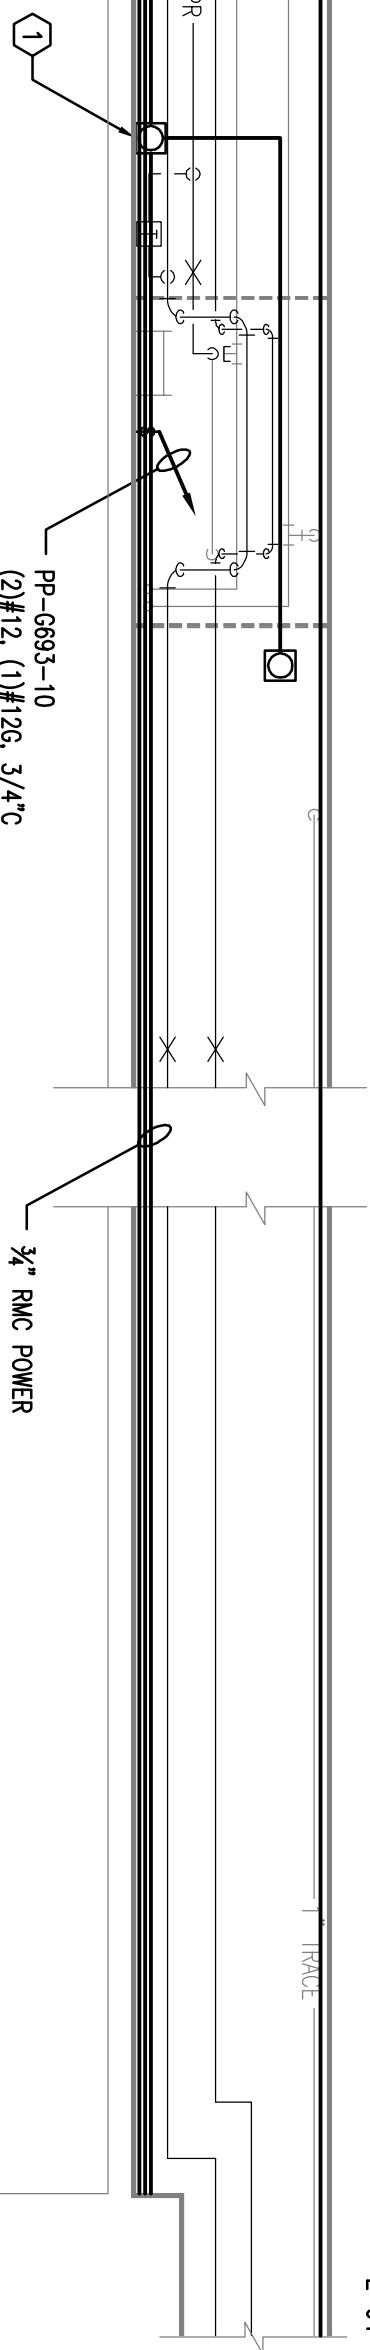

SEE
DWG.
E-01

SEE
DWG.
E-04

LOWER LEVEL PLAN 
SCALE: 1/4"=1'-0"

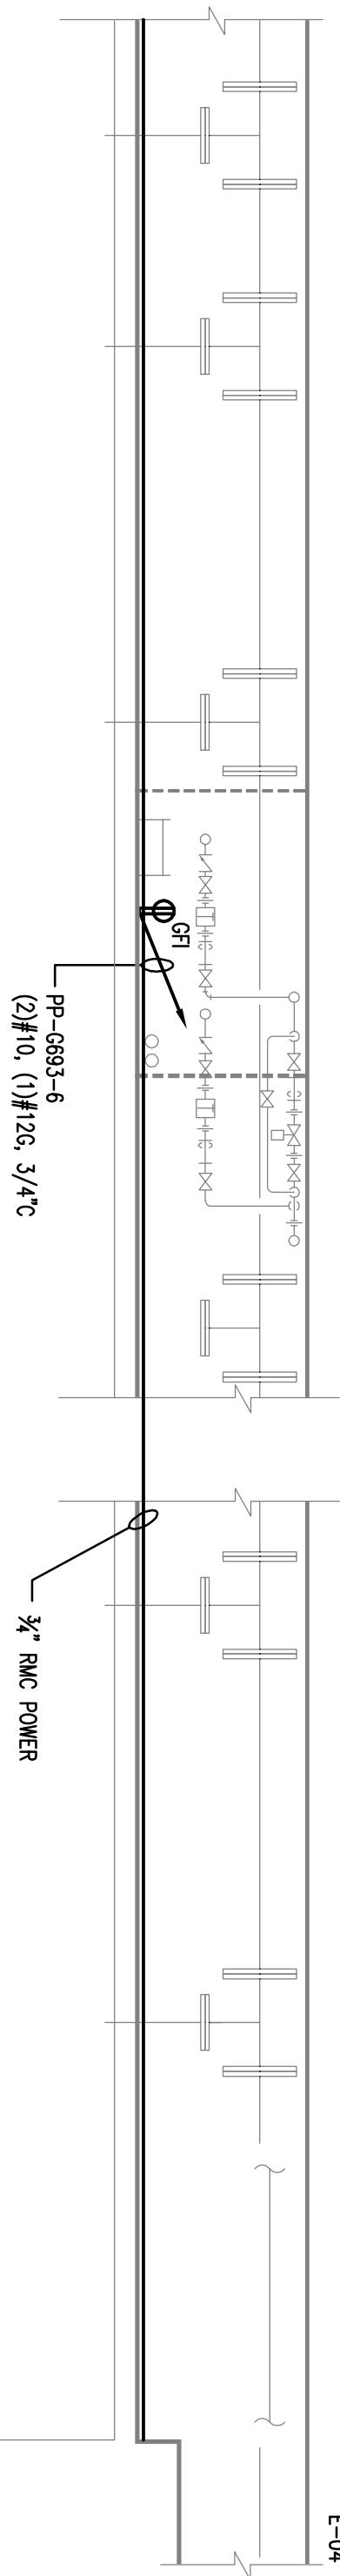

GENERAL NOTES:

- A. RECEPTACLES SHALL BE MOUNTED 48" MINIMUM ABOVE UTILIDOR (OR VAULT) FLOOR.

DRAWING NOTES:

1. LIGHT FIXTURE SHALL BE MOUNTED ON UTILIDOR WALL 6" BELOW MPS PIPING.

| REV. NO. | DATE | DESCRIPTION | FOSDICK & HILMER CONSULTING ENGINEERS 309 VINE STREET, SUITE 50 CINCINNATI, OHIO 45202 TELEPHONE (513)241-5640 WWW.FHENG.COM |
|----------|----------|----------------|---|
| 0 | 05/09/11 | RECORD DRAWING | Jimmy Huntington Building 714 Fourth Avenue, Suite 20 Fairbanks, Alaska 99701 Telephone (907) 455-1500 Fax (907) 455-6788 |

| | | | |
|--|--|---|------------------|
| 714 Fourth Avenue, Suite 20 Fairbanks, Alaska 99701 Telephone (907) 455-1500 Fax (907) 455-6788 | Date: 19 FEB 2010 Scale: 1/4"=1'-0" Designed By: JRS Drawn By: RHW Checked By: EAE DU PROJECT NO. J101395, J101396, J101397 | UTILITY SERVICE EXTENSION TO AIRCRAFT PARTS STORAGE EXISTING VAULT H6-3-3 & UTILIDOR FORT WAINWRIGHT, AK. | Drawing No. E-03 |
|--|--|---|------------------|