

DETAIL GENERAL NOTES:


- A. SEE DOYON UTILITIES STANDARD DRAWING UES-DD-H206 FOR VENT INSTALLATION DETAILS.

DETAIL NOTES:

1. WELD 1/2" HALF NIPPLE TO VENT PIPE FOR SENSOR INSTALLATION.
2. FURNISHED BY DOYON UTILITIES, INSTALLED BY ELECTRICAL CONTRACTOR.

DETAIL 2 OUTDOOR AIR TEMPERATURE TRANSMITTER

PC-04

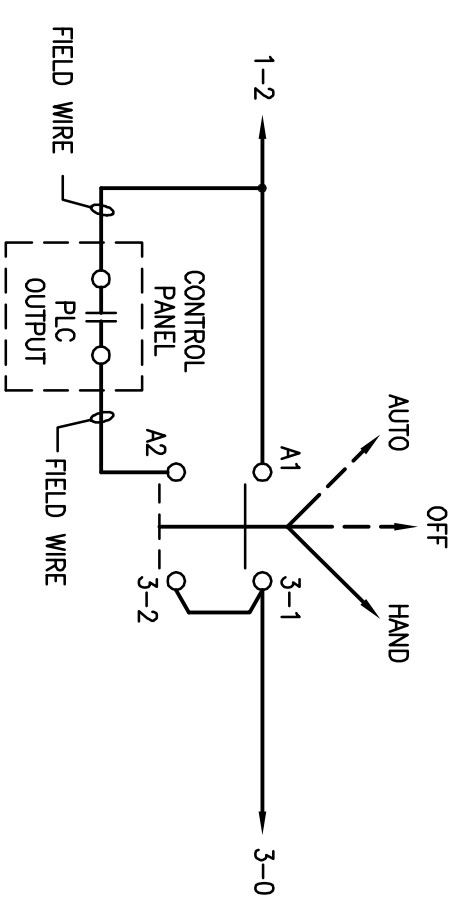


DETAIL GENERAL NOTE:

- A. SEE DOYON UTILITIES STANDARD DRAWING UES-DD-H206 FOR VENT INSTALLATION DETAILS.

DETAIL NOTES:

1. DRILL AND TAP INTAKE VENT PIPE FOR CONNECTION OF DEVICE.

REV. NO.	DATE	DESCRIPTION			Drawing No.
0	05/09/11	RECORD DRAWING			PC-07
		FOSDICK & HILLMER CONSULTING ENGINEERS 308 VINE STREET, SUITE 50 CINCINNATI, OHIO 45202 WWW.FHENG.COM TELEPHONE (513)241-5640			
					
Jimmy Huntington Building 714 Fourth Avenue, Suite 20 Fairbanks, Alaska 99701 Telephone (907) 455-1500 Fax (907) 455-6788			Date: 04/09/10 Scale: NTS Designed By: J.T. Drawn By: J.N. Checked By: J.T.	UTILITY SERVICE EXTENSION TO AIRCRAFT PARTS STORAGE MISCELLANEOUS UTILITY MONITORING DETAILS FORT WAINWRIGHT, AK. DU PROJECT NO. J101395, 101396, 101397	