

LOWER LEVEL PLAN 


SCALE: 1/4"=1'-0"

BUILDING 2080

NOTE: NO NEW DISCIPLINE WORK SHOWN  
ON THIS DRAWING.

UTILIDOR TO  
VAULT G6-9-2

EXISTING  
VAULT  
H6-3-3

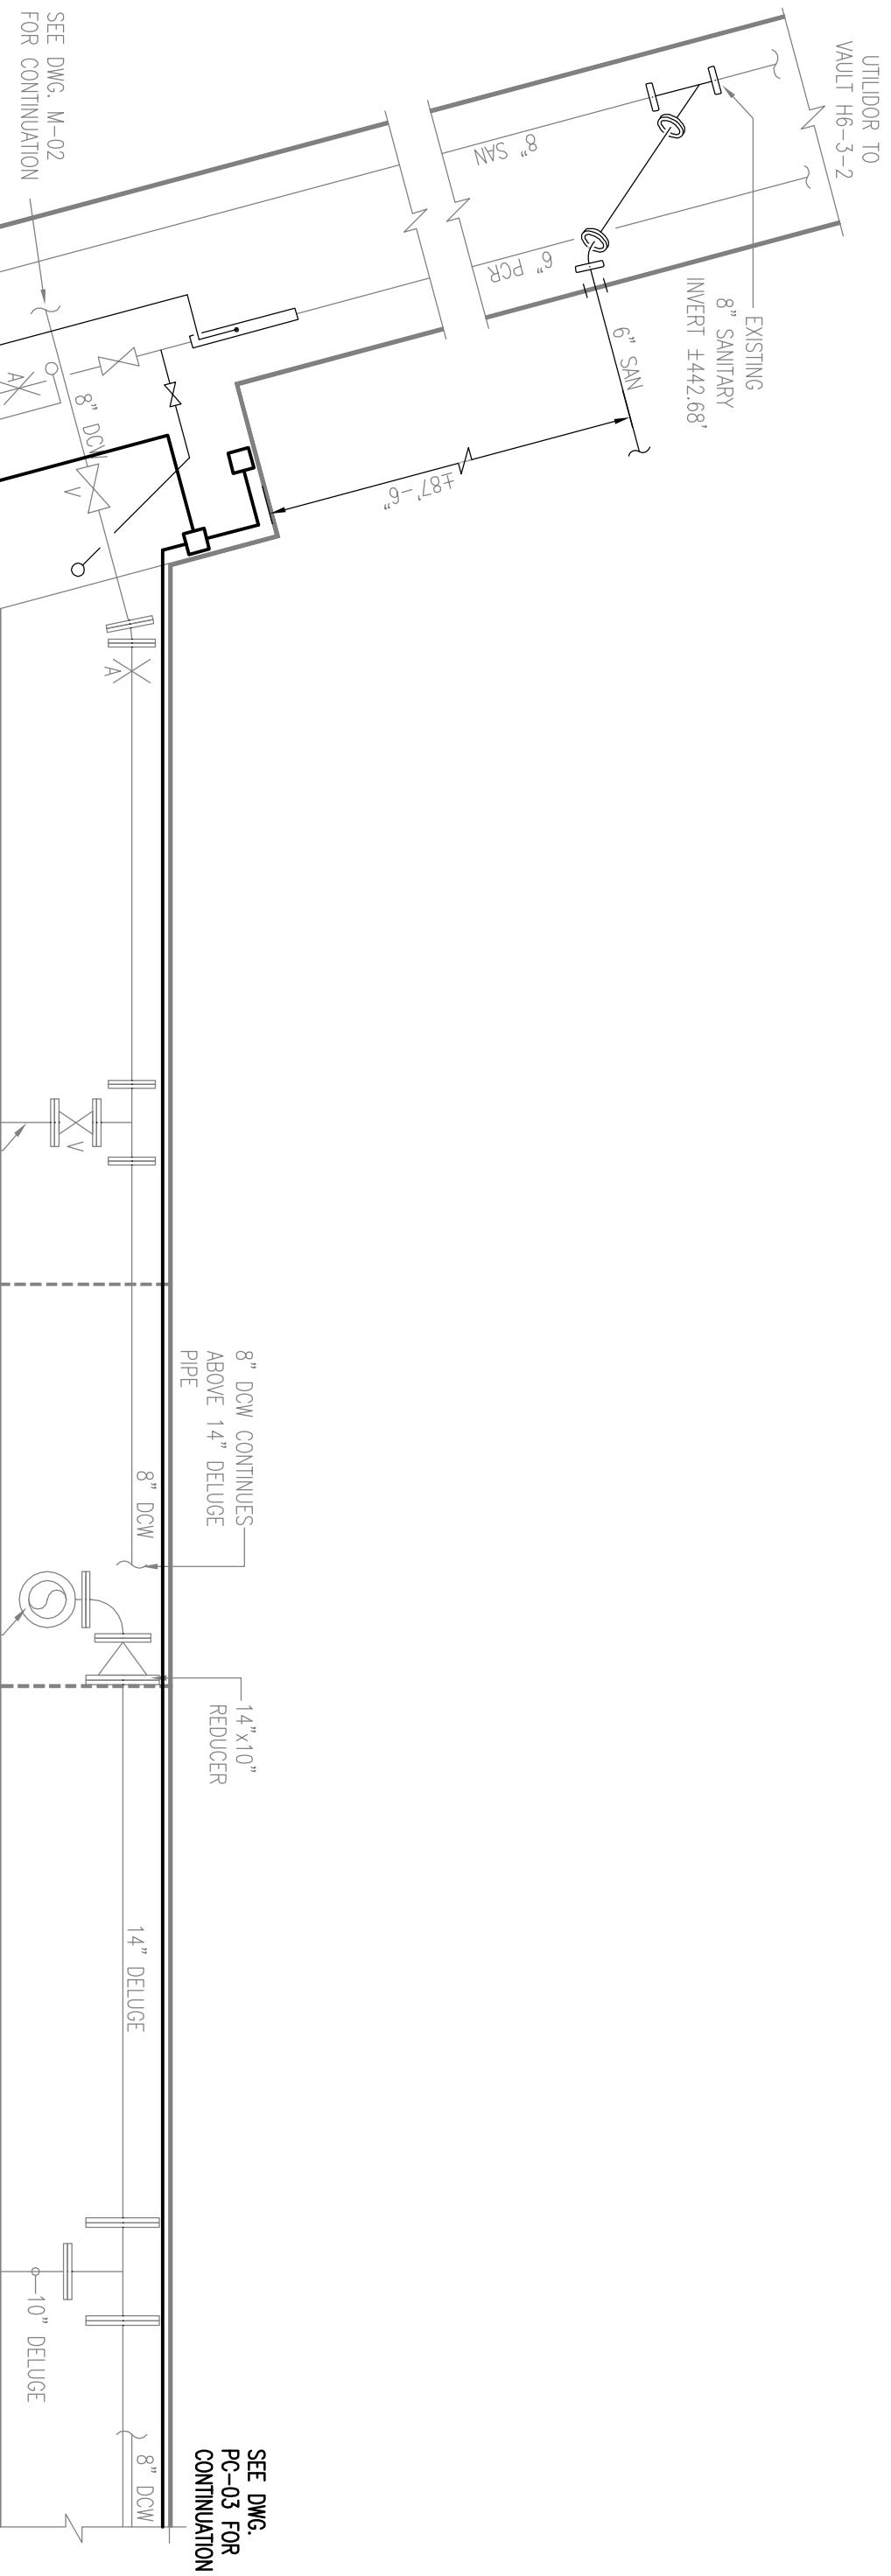

| REV. NO. | DATE     | DESCRIPTION                                                                                                                           | Drawing No. |
|----------|----------|---------------------------------------------------------------------------------------------------------------------------------------|-------------|
| 0        | 05/09/11 | RECORD DRAWING                                                                                                                        |             |
|          |          | FOSDICK & HILMER CONSULTING ENGINEERS<br>309 VINE STREET, SUITE 50 CINCINNATI, OHIO 45202<br>TELEPHONE (513)241-5640<br>WWW.FHENG.COM |             |
|          |          | <br>DOYON UTILITIES                                | PC-01       |

Jimmy Huntington Building  
714 Fourth Avenue, Suite 20  
Fairbanks, Alaska 99701  
Telephone (907) 455-1500  
Fax (907) 455-6788