


DETAIL 6 TEMPERATURE TRANSMITTER

N.T.S.

PC-04

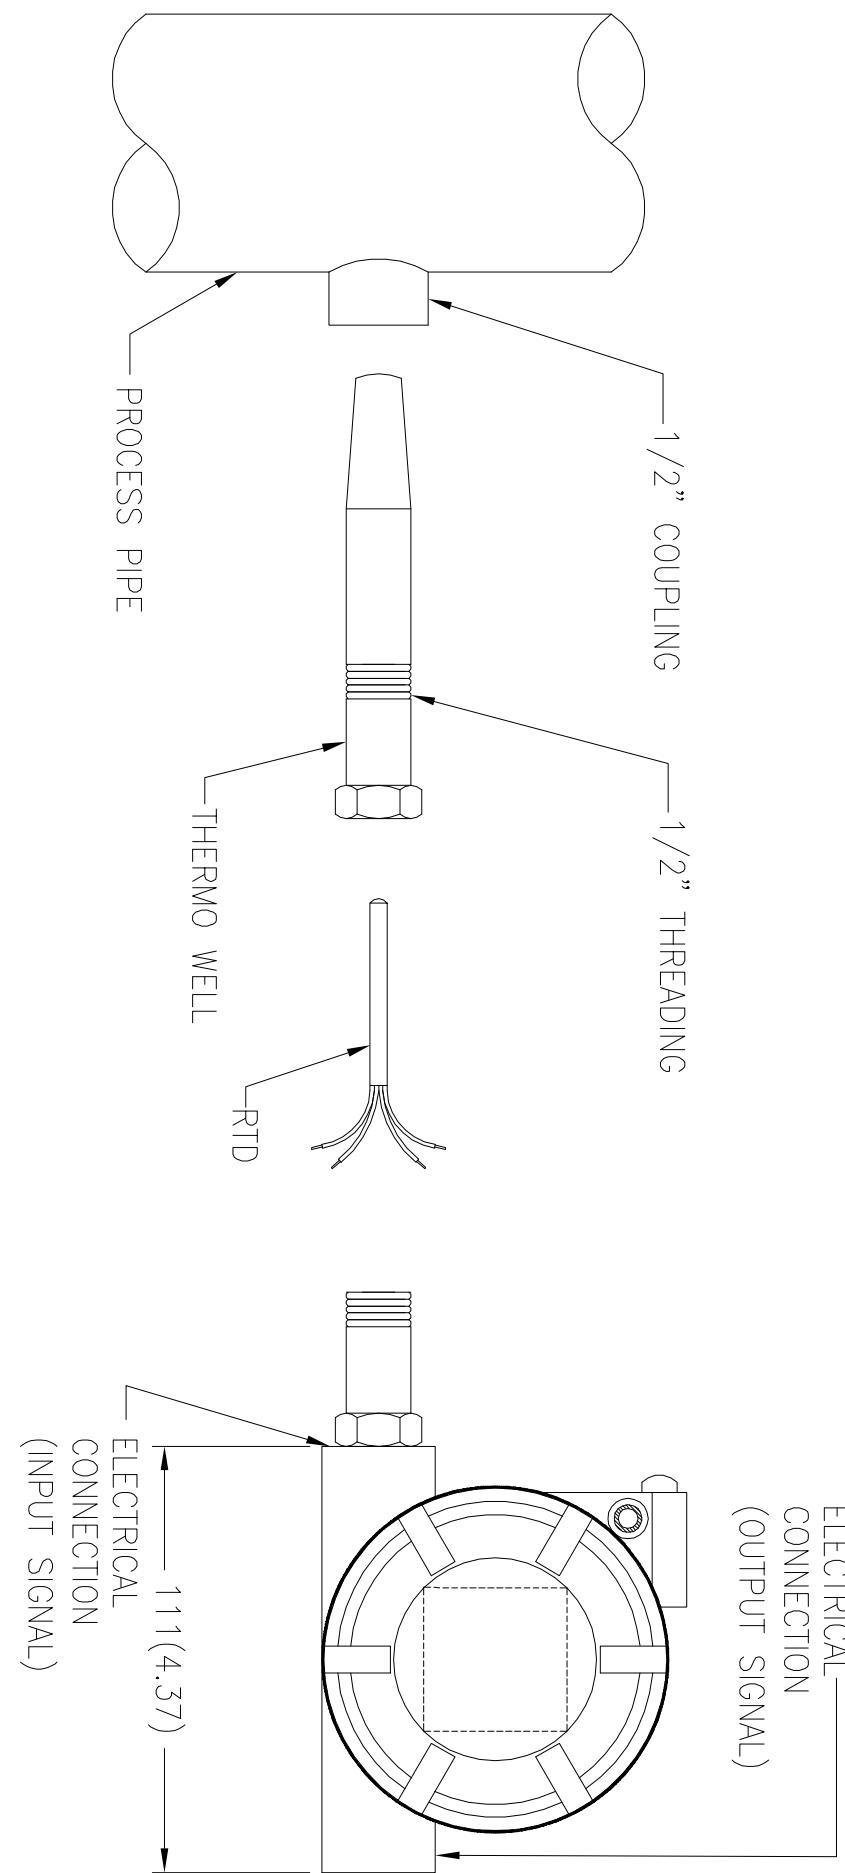

REV. NO.	DATE	DESCRIPTION	Drawing No.
0	05/09/11	RECORD DRAWING	
		FOSDICK & HILMER CONSULTING ENGINEERS 309 VINE STREET, SUITE 50 CINCINNATI, OHIO 45202 TELEPHONE (513)241-5640 WWW.FHENG.COM	
		DOYON UTILITIES 714 Fourth Avenue, Suite 20 Fairbanks, Alaska 99701 Telephone (907) 455-1500 Fax (907) 455-6788	PC-10